Georgia Public Service Commission
Request for Transfer of Retail Electric Service

Pursuant to Section 9 (C)(2) of the Georgia Territorial Electric Service Act [Acts 1973, page 200; O.C.G.A. Section 46-3-8 (c)(2)], the undersigned hereby files this joint (3-party) application for transfer of retail electric service. Commission approval of this request affects only the subject premise; no territorial assignments or unassignments are to change.

This application is not complete without a clear description of the premises location (city/county map, plat, landmark location, etc.) and a copy of the applicable territorial map "B" indicating the location of premises.

Consumer and/or Owner Address

Consumer William Wright

Premise Owner William Wright

Owner's mailing address 2410 Berkley Drive

City Valdosta State GA Zip 31602

Location of Premises to be Transferred

Address Mcneal Road

Parcel ID #0044019A LL 91 LD 12

City Hahira COUNTY Lowndes Zip 31602

Reason or cause for request: Consumer requested due to cost and time frame to serve premise by Georgia Power. Colquitt EMC has power in Georgia Power territory available to serve location. Cost for EMC is significantly less.

Does the transfer include a transfer of utility assets? ☐ Yes ☒ No If yes, list assets on a separate page.

The signatures hereon by the applicants indicate their agreement to this transfer of service.

Supplier Transferring Customer

Georgia Power — Transferor: Print Utility Name — By (Josh Stallings) Title (GM, Planning and Policy) — 12/19/2023 Date


Supplier Receiving Customer

Colquitt EMC — Transferee: Print Utility Name — By (Jason Boykin) Title (District Eng Superintendent) — 12/11/23 Date

Consumer and/or Owner

William A. Wright — Consumer (William A. Wright) — 12/8/23 Date

William A. Wright — Owner (William A. Wright) — 12/8/23 Date

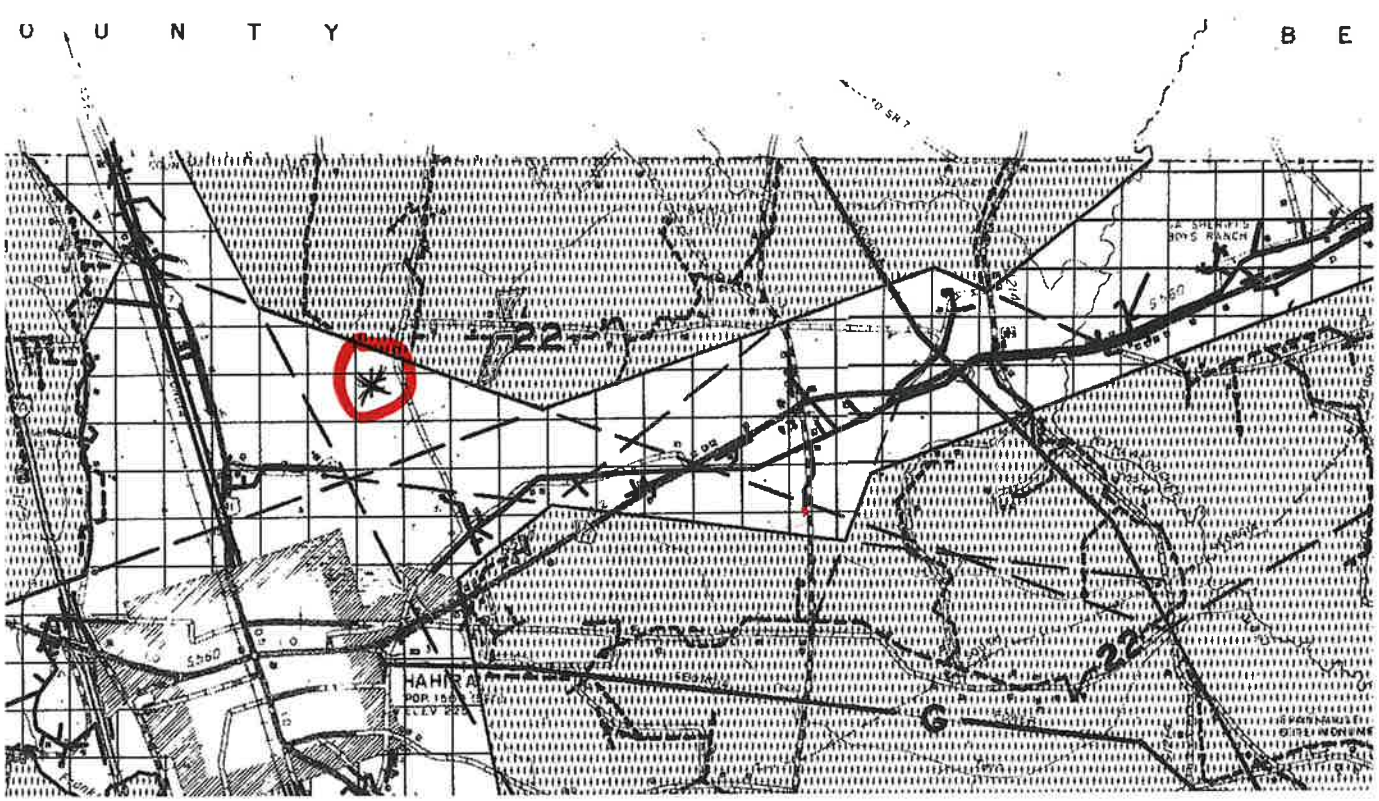
O U N T Y
B E
22
G

eFiled & eRecorded
DATE: 11/6/2023
TIME: 10:07 AM
PLAT BOOK: 000PCC
PAGE: 01645
RECORDING FEES: $10.00
PARTICIPANT ID: 7540271463
CLERK: Beth Greene
Lowndes County, GA

RECEIVED FOR THE CLERK OF SUPERIOR COURT

AS REQUIRED BY SUBSECTION (D) OF O.C.G.A. SECTION 15-6-67, THIS PLAT HAS BEEN PREPARED BY A LAND SURVEYOR AND APPROVED BY ALL APPLICABLE LOCAL JURISDICTIONS FOR RECORDING AS EVIDENCED BY APPROVAL CERTIFICATES, SIGNATURES, STAMPS, OR STATEMENTS HEREON. SUCH APPROVALS OR AFFIRMATIONS SHOULD BE CONFIRMED WITH THE APPROPRIATE GOVERNMENTAL BODIES BY ANY PURCHASER OR USER OF THIS PLAT AS TO INTENDED USE OF ANY PARCEL. FURTHERMORE, THE UNDERSIGNED LAND SURVEYOR CERTIFIES THAT THIS PLAT COMPLIES WITH THE MINIMUM TECHNICAL STANDARDS FOR PROPERTY SURVEYS IN GEORGIA AS SET FORTH IN THE RULES AND REGULATIONS OF THE GEORGIA BOARD OF REGISTRATION FOR PROFESSIONAL ENGINEERS AND LAND SURVEYORS AND AS SET FORTH IN O.C.G.A. SECTION 15-6-67.

RODNEY GENE TENERY, JR./GLS/PE — 10 / 17 / 2023 — DATE

No. 3015 PROFESSIONAL — GEORGIA

THE SURVEYOR SHALL NOT BE HELD LIABLE FOR USE CHANGES FROM THE USE OF THIS PLAT IF THE APPROVAL CHANGES FROM THE KNOWLEDGE DATA GOVERNING AUTHORITIES ARE NOT AWARE OF.

LEGEND

210'	= POWER LINE
	= IRON PIN FOUND
	= IRON PIN SET
	= CALCULATED POINT
	= CRIMPED TOP PIPE FOUND
	= CRIMPED TOP PIPE SET
	= LAND LOT LINE
	= POINT OF BEGINNING
	= POINT OF COMMENCEMENT
	= IRON PIN
	= PROPERTY LINE
	= CENTER LINE
	= RIGHT OF WAY
	= BENCHMARK
	= IRON PIN WITH CAP
	= PAR. POINT
	= POINT OF CURVATURE
	= POINT OF TANGENCY
	= GROUND WIRE

SURVEY EQUIPMENT USED

- LEICA 1203 TOTAL STATION & SOC
- SOKKIA 230W 90 TOTAL ST STATION
- 230W TOPCON TOTAL STATION & SOC
- 200' STEEL METAL TAPE
- DST AUTO LEVEL
- TDS RANGER DATA COLLECTOR W/ SURVEY PRO SOFTWARE
- CARLSON SURVEYOR & COLLECTOR W/ CARLSON SE 2 SOFTWARE
- CHAMPION PRO GNSS RECEIVER
- SECRETER DATA COLLECTOR W/ CARLSON SE 2 SOFTWARE

BEARINGS SHOWN HEREON HAVE BEEN CALCULATED FROM ANGLES TURNED AND ARE REFERENCED TO GEORGIA STATE PLANE GRID NORTH - WEST ZONE

RODNEY GENE TENERY, JR
GA L.S. NO 3015
EROSION & SEDIMENT CONTROL
LEVEL II CERTIFIED DESIGN PROFESSIONAL
RODNEY GENE TENERY, JR CERTIFICATION # 5255

I CERTIFY THAT ALL MEASUREMENTS ARE CORRECT AND WERE PREPARED FROM AN ACTUAL SURVEY OF THE PROPERTY MADE UNDER MY DIRECT SUPERVISION. THE FIELD DATA UPON WHICH THIS PLAT IS BASED HAS A RELATIVE POSITIONAL ACCURACY AS CALCULATED ACCORDING TO THE FEDERAL GEOGRAPHIC DATA COMMITTEE PART 3 NATIONAL STANDARD FOR SPATIAL DATA ACCURACY IS 0.01 FEET HORIZONTAL AND 0.02 FEET VERTICAL AT A 95% CONFIDENCE LEVEL. THIS PLAT HAS BEEN CALCULATED FOR CLOSURE AND HAS BEEN FOUND TO HAVE A CLOSURE OF ONE FOOT N 1,268,845.0 FEET. MONUMENTS AND PINS ARE AS SHOWN IN THE LEGEND ON THE PLAT FACE.
GA CERTIFICATE OF AUTHORIZATION # LSF 926
GA BUSINESS LICENSE NO 2524

0' 200' 400' 600'
GRAPHIC SCALE
1" = 200'

THE FOLLOWING GOVERNMENTAL BODIES HAVE APPROVED THIS MAP, PLAT OR PLAN FOR FILING:

LOWNDES COUNTY UNIFIED LAND DEVELOPMENT CODE ADMINISTRATIVE TECHNICAL REVIEW COMMITTEE — 10/18/2023 — DATE

LOWNDES COUNTY DIRECTOR OF ENGINEERING — 10/18/2023 — DATE


GENERAL NOTES:

1. NO UNDERGROUND UTILITIES WERE VERIFIED OR FIELD LOCATED ON THE PROPERTY DEPICTED ON THIS SURVEY PLAT. PRIME CONSULTING SOLUTIONS DOES NOT GUARANTEE THAT ALL EASEMENTS THAT MAY AFFECT THIS PROPERTY ARE SHOWN ON THIS PLAT.
2. ACCORDING TO FLOOD INSURANCE RATE MAP NO. 13185C0050E, DATED: SEPTEMBER 26, 2008 THIS PROPERTY IS LOCATED IN FLOOD ZONE " X "
3. THE PURPOSE OF THIS PLAT IS TO PROVIDE A COMBINATION SURVEY OF PART OF THAT PROPERTY DESCRIBED IN DEED BOOK 6356 AT PAGE 005 SHOWING SHERRY COLVIN AS THE GRANTEE AND A PART OF THAT PROPERTY DESCRIBED IN DEED BOOK 5916 AT PAGE 146 SHOWING THE LANGDALE COMPANY AS THE GRANTEE, PRIME CONSULTING SOLUTIONS, INC. WAS ENGAGED TO PERFORM THIS SURVEY BY DR. WILL WRIGHT.
4. THE TWO OPEN DITCHES SHOWN HEREON ARE IN PLACE AS SHOWN, HOWEVER THE UNDERSIGNED HAS NOT LOCATED A DOCUMENT GRANTING AN EASEMENT FOR EITHER DITCH.
5. THE HIGHWATER ELEVATION FOR THE WETLANDS SHOWN HEREON IS 210' AS INTERPOLATED BY THE UNDERSIGNED FROM THE U.S.G.S. QUADRANGLE MAP FOR NEW LOIS.
6. THE MINIMUM FINISHED FLOOR ELEVATION FOR THIS PROPERTY WILL BE 212'

GPS NOTES:

1. GPS WAS USED FOR THE CONTROL NETWORK FOR THIS SURVEY.
2. THE TYPE OF GPS EQUIPMENT USED: CHAMPION TWO RECEIVER DUAL FREQUENCY, RECEIVING CORRECTIONS FROM THE eGPS VRS NETWORK.
3. THE TYPE OF GPS SURVEY PERFORMED WAS A RTK SURVEY USING THE eGPS VRS NETWORK FOR THE GPS CONTROL.
4. THE RELATIVE POSITIONAL ACCURACY AS CALCULATED ACCORDING TO THE FEDERAL GEOGRAPHIC DATA COMMITTEE PART 3: NATIONAL STANDARD FOR SPATIAL DATA ACCURACY IS 0.01 FEET HORIZONTAL AND 0.02 FEET VERTICAL AT A 95% CONFIDENCE LEVEL.

Red mark indicates Colquitt EMC power pole

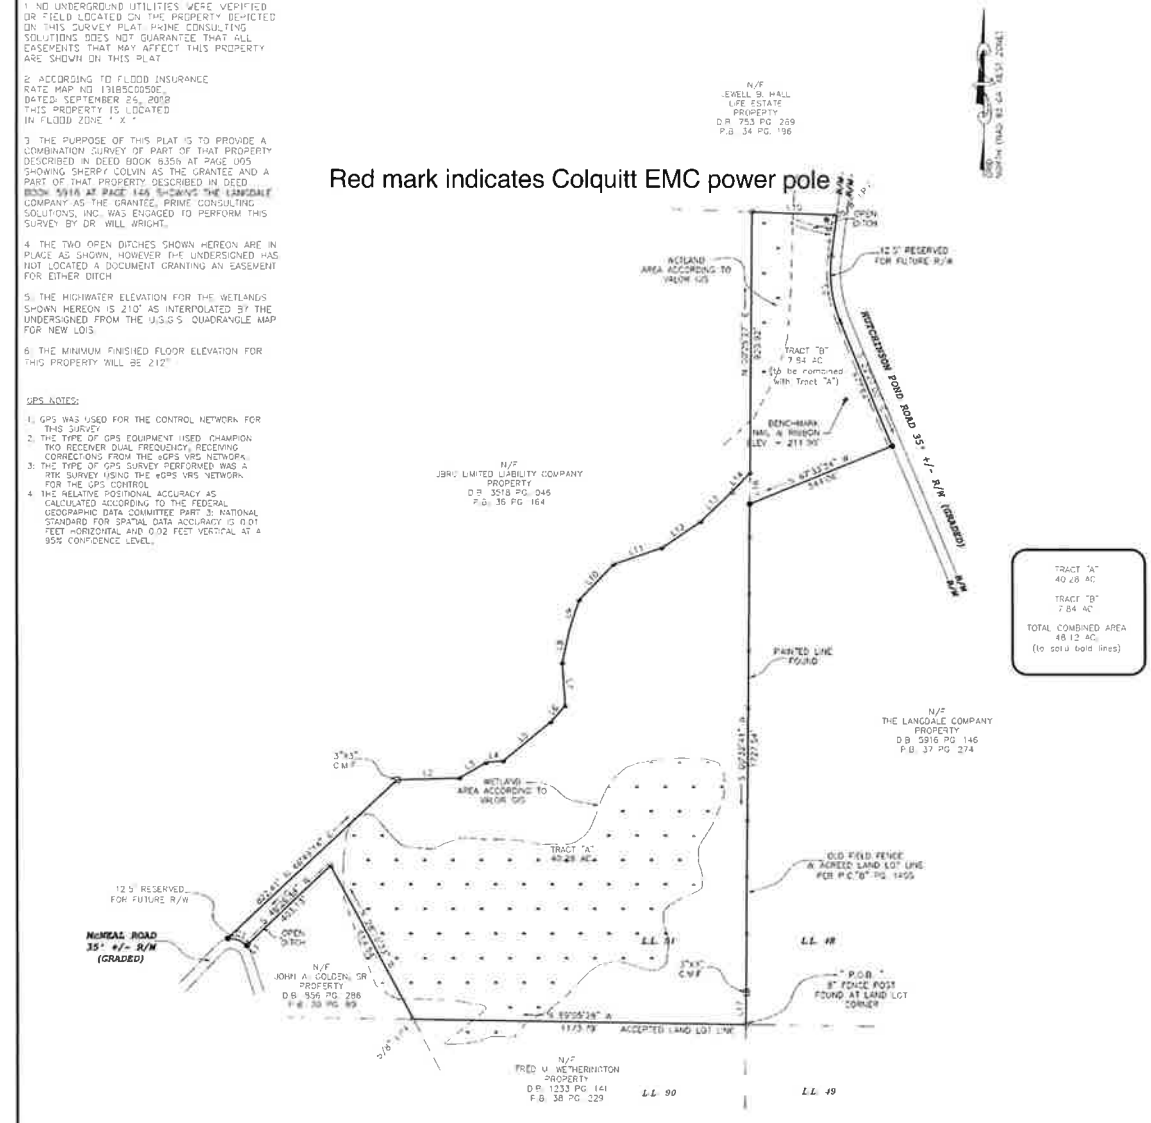

LINE	BEARING	DISTANCE
L1	N 87°37'46" W	60.00'
L2	N 87°37'46" W	60.00'
L3	N 59°31'06" E	105.73'
L4	N 78°55'23" E	60.37'
L5	N 87°37'46" W	179.93'
L6	N 87°37'46" W	25.01'
L7	N 09°45'13" W	151.15'
L8	N 17°11'41" E	114.55'
L9	N 18°18'39" E	113.43'
L10	N 44°00'27" E	137.91'
L11	N 71°09'41" E	119.09'
L12	N 35°55'29" E	113.21'
L13	N 40°45'06" E	105.50'
L14	N 87°37'46" W	27.89'
L15	S 87°55'32" E	22.72'
L16	S 09°21'05" W	140.33'
L17	S 09°21'05" W	111.53'
L18	N 09°21'05" E	111.00'

CURVE	RADIUS	ARC LENGTH	CHORD BEARING	CHORD DISTANCE	DELTA ANGLE
C1	457.00'	172.28'	N 20°05'13" W	171.26'	21°36'00"
C2	457.00'	233.55'	N 09°33'59" W	231.01'	29°45'18"

GEORGIA, LOWNDES COUNTY
UNIFIED LAND DEVELOPMENT CODE
APPROVED
This 18th day of October, 2023 9:53 am
File Number COM-2023-17
Chairman, Technical Review Committee

THIS IS A SURVEY OF LAND PARCEL 019A ON TAX MAP 044 & PART OF LAND PARCEL 001 ON TAX MAP 045

SURVEY FOR:
WILL WRIGHT
LOCATED IN LAND LOTS 48 & 91 OF THE 12TH LAND DISTRICT OF LOWNDES COUNTY, GEORGIA

DATE OF FIELD SURVEY
08 / 18 — 09 / 08 / 2023
DATE OF PLAT
10 / 17 / 2023

Prime Consulting Solutions
Land Surveying, Land Planning, Mapping & Consulting Forestry Solutions
2621 U.S. HIGHWAY 84 EAST
VALDOSTA, GA. 31606
PH. 229-244-9735
FAX 229-244-9761
E-MAIL harold@primeslsolutions.net

JOB ID # 9-14575