
Card Location Details

Previous | Next | Previous Result | Next Result

Card Details

Back

Card Details | Log Issue

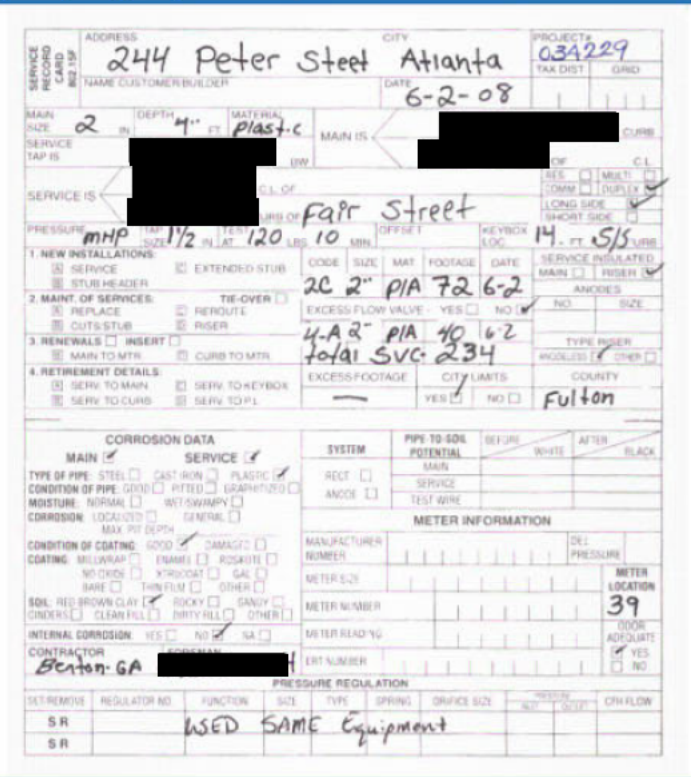

SERVICE RECORD CARD

ADDRESS 244 Peter Steet CITY Atlanta PROJECT# 03A229

NAME CUSTOMER/BUILDER DATE 6-2-08 TAX DIST GRID

MAIN SIZE 2 IN DEPTH 4" FT MATERIAL plast-c MAIN IS [redacted] CURB

SERVICE TAP IS [redacted] DW

SERVICE IS [redacted] C.L. OF

CURB OF Fair Street

PRESSURE mHP TAP SIZE 1½ IN TEST AT 120 LBS 10 MIN OFFSET KEYBOX LOC. 14 FT S/S CURB

1. NEW INSTALLATIONS: A SERVICE B STUB/HEADER C EXTENDED STUB

2. MAINT. OF SERVICES: A REPLACE B CUTS STUB C REROUTE D RISER TIE-OVER

3. RENEWALS INSERT A MAIN TO MTR B CURB TO MTR

4. RETIREMENT DETAILS: A SERV. TO MAIN B SERV. TO CURB C SERV. TO KEYBOX D SERV. TO P.L.

CODE	SIZE	MAT.	FOOTAGE	DATE
2C	2"	P/A	72	6-2
4-A	2"	P/A	40	6-2
total SVC: 234				

EXCESS FLOW VALVE - YES NO

SERVICE INSULATED: MAIN RISER

ANODES: NO SIZE

TYPE RISER: ANODELESS OTHER

EXCESS FOOTAGE — CITY LIMITS: YES NO

COUNTY: Fulton

CORROSION DATA

MAIN SERVICE

TYPE OF PIPE: STEEL CAST IRON PLASTIC

CONDITION OF PIPE: GOOD PITTED GRAPHITIZED

MOISTURE: NORMAL WET/SWAMPY

CORROSION: LOCALIZED GENERAL MAX. PIT DEPTH

CONDITION OF COATING: GOOD DAMAGED

COATING: MILLWRAP ENAMEL ROSKOTE NO OXIDE KYNOCOAT GAL BARE THIN FILM OTHER

SOIL: RED-BROWN CLAY ROCKY SANDY CINDERS CLEAN FILL DIRTY FILL OTHER

INTERNAL CORROSION: YES NO NA

CONTRACTOR Berton GA FOREMAN [redacted]H

SYSTEM	PIPE-TO-SOIL POTENTIAL	BEFORE (WHITE)	AFTER (BLACK)
RECT	MAIN		
ANODE	SERVICE		
	TEST WIRE		

METER INFORMATION

MANUFACTURER NUMBER | DIAL PRESSURE | METER SIZE | METER NUMBER | METER READING | ERT NUMBER | METER LOCATION 39 | DOOR ADEQUATE YES NO

PRESSURE REGULATION

SET/REMOVE	REGULATOR NO.	FUNCTION	SIZE	TYPE	SPRING	ORIFICE SIZE	PRESSURE IN	PRESSURE OUT	CFH FLOW
SR		USED SAME Equipment							
SR									

Additional Information

Attachments | Service History | Stapled Group | Exceptions

No Attachments found